The information contained in this drawing is the confidential property of Platinum Energy Services Corp. No part thereof shall be reproduced or communicated to a third party without written authorization from Platinum Energy Services Corp.

FABRICATION NORTH

TIE-IN SCHEDULE			
MARK	SIZE / RATING	ELEVATION	DESCRIPTION
TP-A	3" 600#	12" [305]	HEADER INLET
TP-B	3" 600#	12" [305]	HEADER INLET
TP-C	3" 600#	12" [305]	HEADER INLET
TP-D	3" 600#	12" [305]	HEADER INLET
TP-E	3" 600#	12" [305]	GROUP OUTLET
TP-F	2" NPT	87 1/4" [2217]	PSV-101 OUTLET
TP-G	2" NPT	4" [102]	DRAIN OUTLET
TP-H	1" NPT	78 1/4" [1988]	PSV-200 OUTLET

NOTE: ALL ELEVATION DIMENSIONS FROM TOP OF CHECKER PLATE.

ELEVEN (11) UNITS REQUIRED
21196-GA-02
21197-GA-02
21198-GA-02

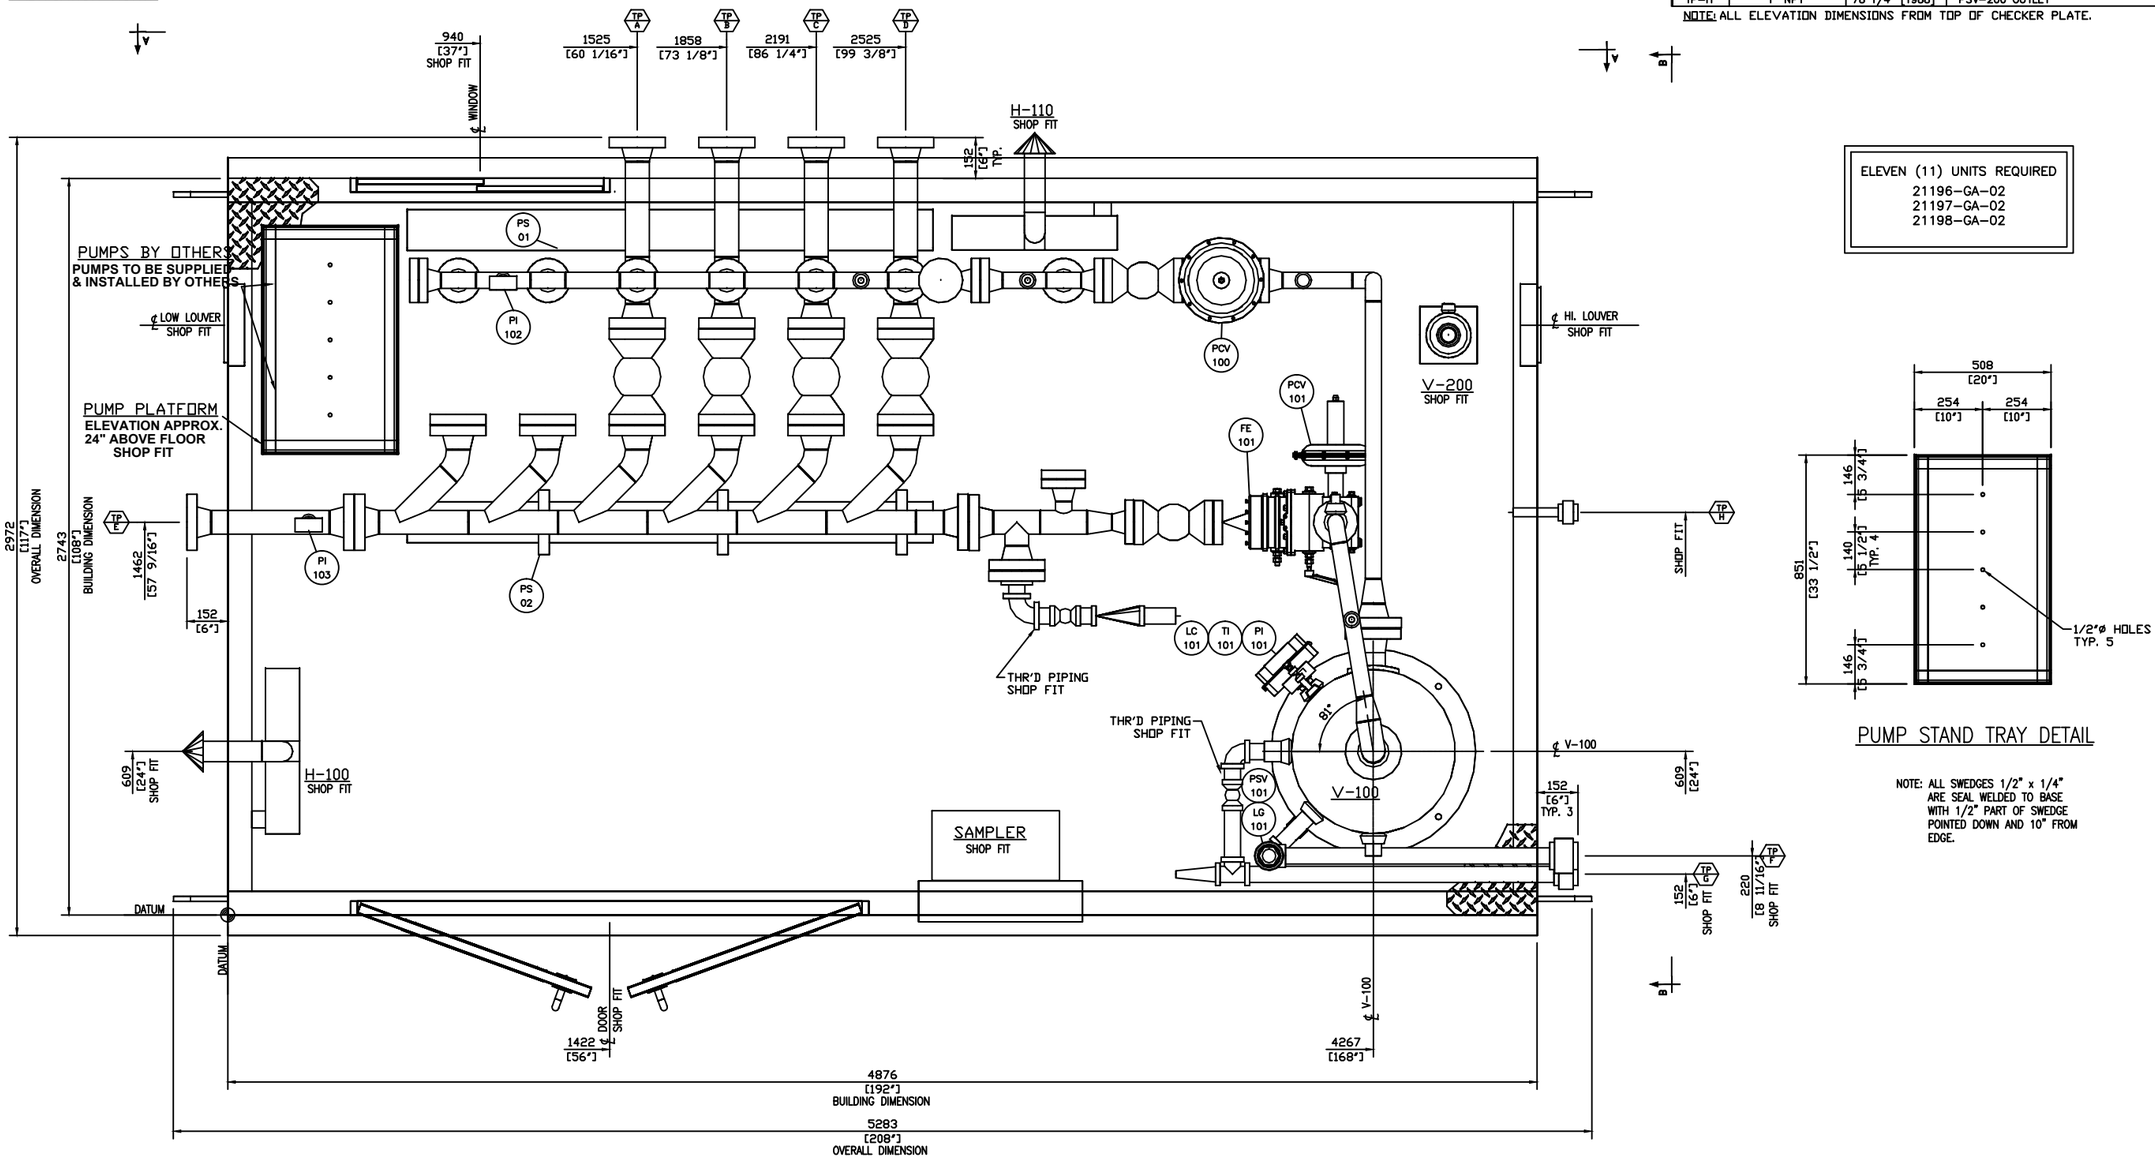

PLAN VIEW

PUMP STAND TRAY DETAIL

NOTE: ALL SWEDGES 1/2" x 1/4" ARE SEAL WELDED TO BASE WITH 1/2" PART OF SWEDGE POINTED DOWN AND 10" FROM EDGE.

NOTES:

REV	DESCRIPTION	BY	DATE	CHK'D	APP'D
3	AS BUILT	CL	14-01-20	BX	RWS
2	REMOVED PUMPS SYMBOL AND REVISED AS NOTED	CL	14-01-14	BX	RWS
1	AS BUILT	EB	13-07-30	BX	RWS
0	ISSUED FOR CONSTRUCTION	CL	13-06-12	BX	RWS
B	REVISED AS PER P&ID REVISION B AND AS NOTED	LL	13-06-05	BX	RWS
A	ISSUED FOR APPROVAL	LL	13-05-28	BX	RWS

REFERENCE DRAWINGS

ENGINEER'S STAMP

DRAWN BY	LL	13-05-28
CHK'D BY	BX	13-05-28
APP'D BY	RWS	13-05-28
CAD REF	21196-GA-02.DWG	
SCALE	AS SHOWN	

PLATINUM Energy Services Corp. CALGARY, ALBERTA

CLIENT: PROGRESS ENERGY CANADA LTD.

TITLE: 24"x7'-6" 1440 PSI 3PH DRESS 2PH TEST SEPARATOR c/w PROVISIONS FOR 6 WELL HEADER -GA- PLAN VIEW

JOB NO. 21196-21198 | DRAWING NO. 21196-GA-02 | REV 3

S:\TRANSFERS\UNIT NUMBER'S\21000\21196-21198\21196-GA-01.DWG